


# SITE STAGING LEGEND

- STAGE 1A**  
FIELD OF PLAY INCLUDING  
LOWER SEATING TERRACES & CONCOURSE
- STAGE 1B**  
BRISBANE LIONS TAF & COMMUNITY BUILDINGS  
INCLUDING MAIN ENTRY PLAZA
- STAGE 1C**  
WESTERN GRANDSTAND & GRASS SPECTATOR  
BERM INCL. NORTHERN CARPARKING
- STAGE 1D**  
SPORTS LIGHTING TOWERS
- STAGE 2**  
COMMERCIAL / ANCILLARY BUILDINGS

## Attachment 6 - Approved Plans

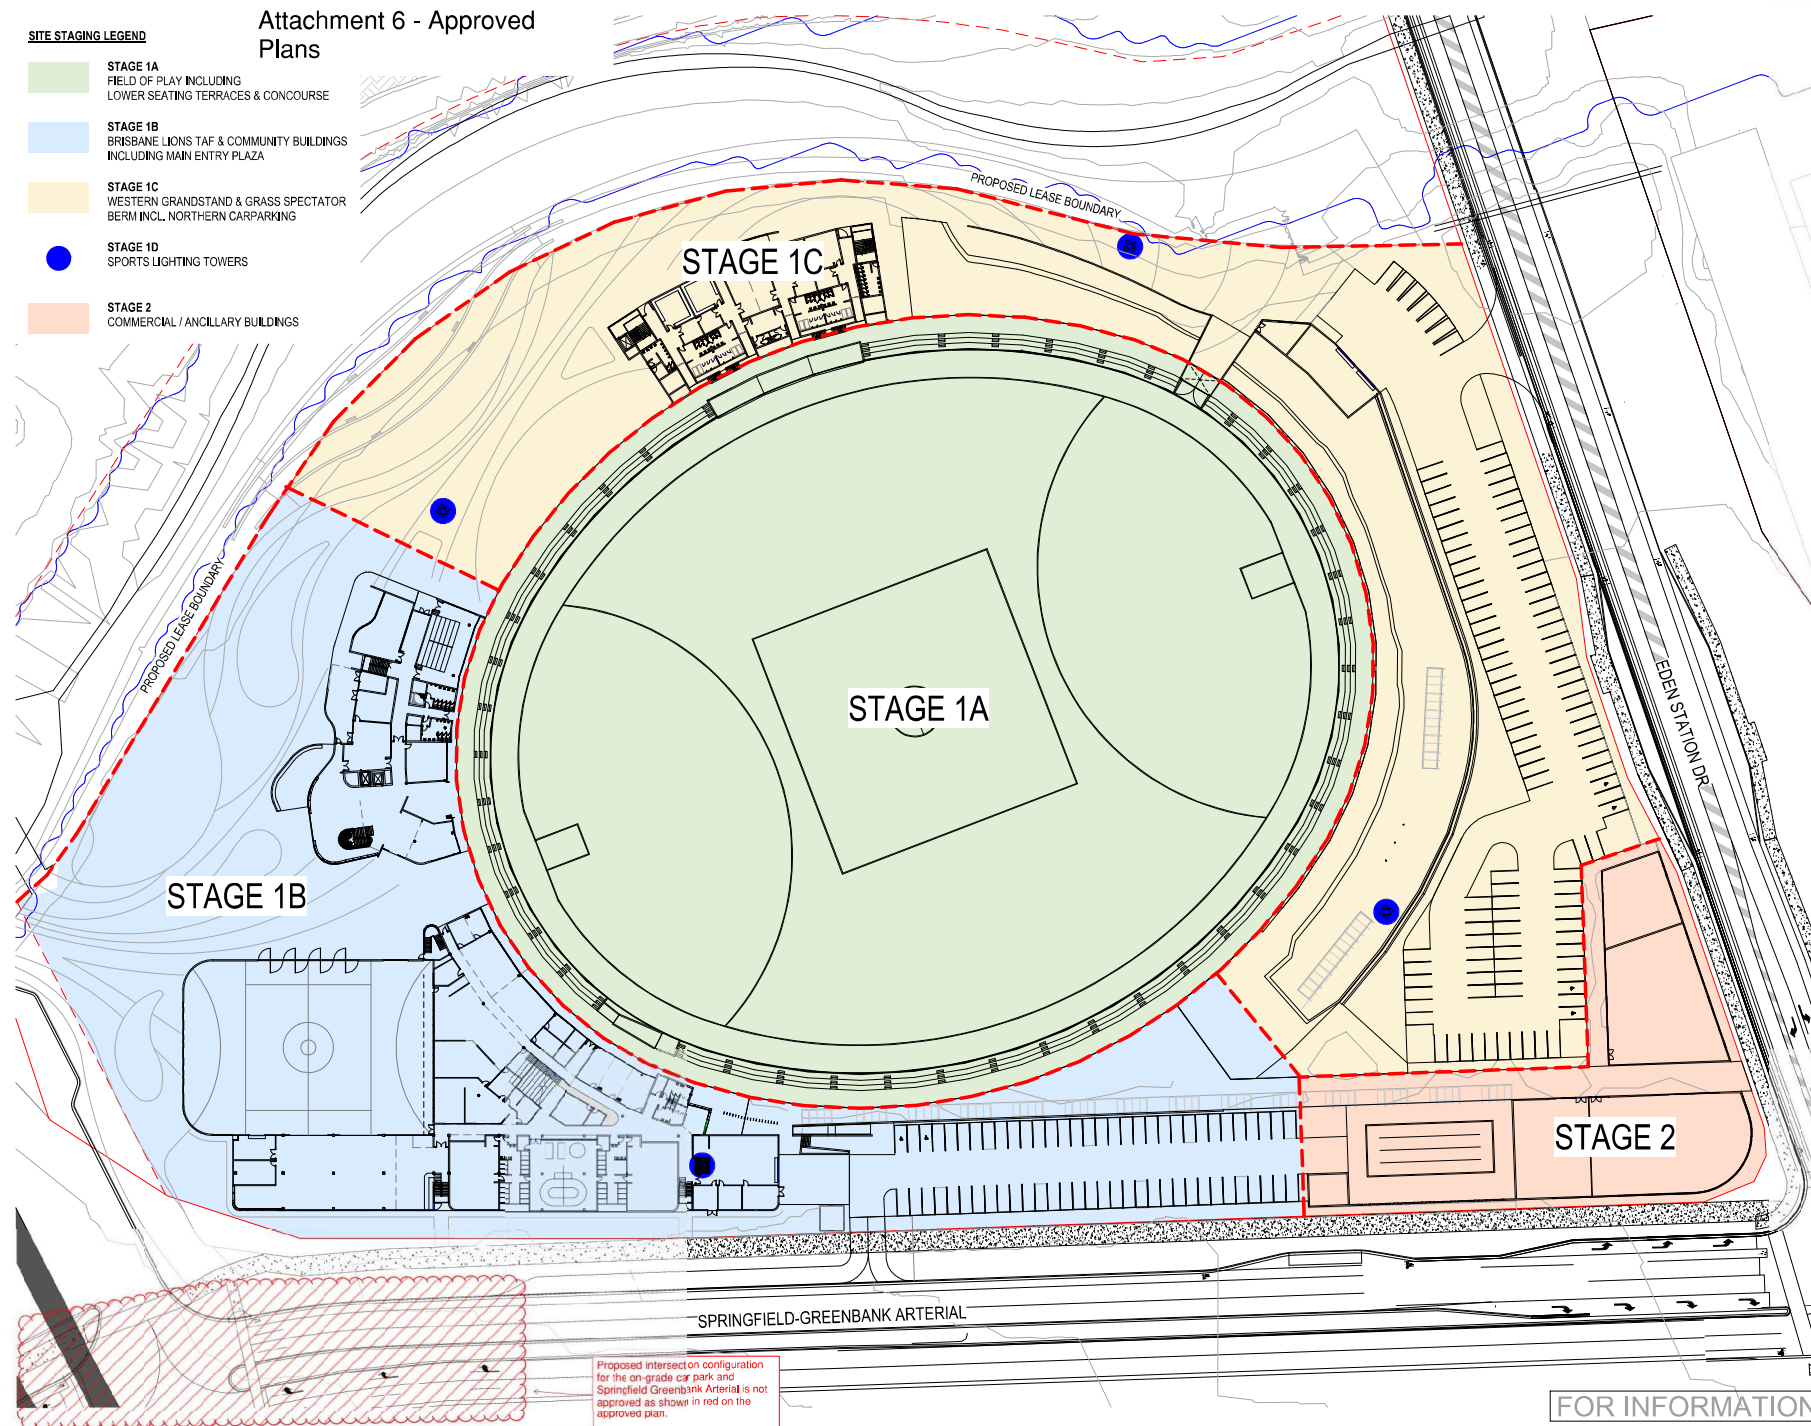

Proposed intersection configuration  
for the on-grade car park and  
Springfield Greenbank Arterial is not  
approved as shown in red on the  
approved plan.

### REFERENCE MAP

Permitted to the Planning Act  
2016, this plan forms part of  
Council's approval for  
Approved Plan 101110219  
Date: 15 July 2020  
Signed: [Signature]

0 10 20 40m  
1:500  
CLIENT



### PROJECT MANAGER

COHA

### STRUCTURAL ENGINEER

NORTHROP

### BUILDING SERVICES ENGINEER

aurecon

### CIVIL ENGINEER & LANDSCAPE ARCHITECT

Cardno

### COST CONSULTANT

NB Napier & Bakeley

### NOTES

### DISCLAIMER

USE FIGURED DIMENSIONS ONLY DO NOT SCALE  
FROM DRAWING CHECK & VERIFY ALL DIMENSIONS  
ON SITE BEFORE FABRICATION OR SET OUT.  
This drawing is diagrammatic and shows general arrangements.  
Any information making measurement of the works shall be taken  
from coordinated dimensions on the architectural and structural  
drawings, workshop drawings by others and conditions on site. The  
works shall comply with the contract conditions and Statutory  
Provisions.  
All rights reserved. This work is copyright and cannot be  
reproduced or copied in any form or by any means graphic,  
electronic or mechanical, including photocopying without the written  
permission of Populous and its associated, Affiliates.  
expressed or implied, to use this document for any purpose  
other than as intended in the terms of the agreement or implied  
agreement between Populous and the instructing party.

### THIS DRAWING IS AN UNCONTROLLED COPY, UNLESS NOTED OTHERWISE

REV	DESCRIPTION	DATE
1	DATE OF REV	10/01/2019
2	DATE OF REV	03/07/2019
3	DATE OF REV	
4	DATE OF REV	
5	DATE OF REV	
6	DATE OF REV	
7	DATE OF REV	
8	DATE OF REV	
9	DATE OF REV	
10	DATE OF REV	

### ARCHITECT

POPULOUS

BRISBANE  
71 Boundary Street  
GPO Box 5200  
Brisbane QLD 4000  
AUSTRALIA  
P +61 (0)7 3338 1900  
F +61 (0)7 3338 1918  
www.populous.com  
E-mail: sport.au@populous.com

### PROJECT

BRISBANE LIONS TRAINING FACILITY  
THE RESERVE, SPRINGFIELD CENTRAL

### SHEET TITLE

SITE STAGING PLAN

### PROJECT NUMBER

18,7545.00

### COORDINATED

SP

### SCALE 1:100 @ A1

As indicated

### REVISED

BG

### APPROVED

WC

### REVISION

B

FOR INFORMATION

ORIGINAL SHEET SIZE A1 - 841mm x 1189mm